EXISTING CEMETERY (GREENWOOD)		REINTERMENT CEMETERY (STEAMBURG)			
GRAVE NO.	NAME OF INTERRED	SECTION	BLOCK	LOT	SPACE
231	CLARA WHITE	1	C	9	3
232	MARTIN WHITE	1	C	9	4
233	JOS. W. MEAD	1	C	14	1
234	MARY MEAD	1	C	14	2
235	FLORENCE L. BOUTELL	1	C	19	1
236	ALBERT ROFF	1	C	19	2
237	(NOT APPLICABLE)				
238	JANE J. RYDER	1	C	24	3
239	WILLIAM RYDER	1	C	24	4
240	LOUISE ELNORA CARR	1	A	4	6
241	MARION CARR	1	A	4	7
242	ELINOR CARR	1	A	4	8
243	HENRY HERTEL	1	A	9	5
244	REBECCA HERTEL	1	A	9	6
245	WALTER G. STODDARD	1	A	24	6
246	HIRAM L. BROWN	1	C	24	8
247	ELIZA DECKER	1	A	3	1
248	GEORGE DECKER	1	A	3	3
249	LEWIS A. BOVA	1	A	8	1
250	ALICE BOVA	1	A	8	3
251	MRS. GEORGE MELLEN	1	A	13	4
252	WM. MARSH	1	A	18	1
253	ROSETTA MARSH	1	A	18	2
254	MARY ANN MURRAY	1	A	23	1
255	PETER S RHODES	1	A	23A	1
256	MARY HEIDELL	1	A	28	2
257	HENRY HEIDELL	1	A	28	3
258	JESSIE M GODFREY	1	C	13	2
259	JULUS C. BROWN	1	C	18	2
260	MARY E. BROWN	1	C	18	3
261	ELLA KILBURN	1	C	18	4
262	ADELAIDE E. ARMSTRONG	1	A	3	6
263	EUNICE C. SHEFFIELD	1	A	3	7
264	ALBERT SHEFFIELD	1	A	3	8
265	JOHN ALBERT BOVA	1	A	8	7
266	(NOT APPLICABLE)				
267	WALTER J. BROWN	1	A	23A	4
268	FRANCIS M. HALLOCK	1	C	3	6
269	LILLIAN AGNES HALLOCK	1	C	3	7
270	EMMETT LEON HALLOCK	1	C	3	8
271	ANNA CORNELIUS	1	C	8	4
272	CHARLOTTE M HILL	1	C	8A	4
273	FRED A. GODFREY	1	C	13	3
274	LAFAYETTE BROWN	1	C	18	5
275	CLEVELAND G. HOLLIS	1	C	18	6
276	MINA MAUDE YEAGER	1	A	2	3
277	JOHN B. YEAGER	1	A	2	2
278	RALPH A. YEAGER	1	A	2	1
279	MARVIN T. HUBBARD	1	A	7	2
280	FRANCES A. HUBBARD	1	A	7	1
281	GEORGE HUBBARD	1	A	7	3
282	SADIE C. HUBBARD	1	A	7	4
283	FRANK BANKS	1	A	12	2
284	MRS WILLIAM BANKS	1	A	12	3
285	WILLIAM BANKS	1	A	12	4
286	ALBERT FRANCIS BOVA	1	A	17	2
287	DANIEL FRINK	1	A	17	4
288	THEODORE KRECKO	1	A	22	1
289	MRS. JOHN KRECKO	1	A	22	2
290	JOHN KRECKO	1	A	22	3
291	CHARLES S. ALDRICH	1	A	27	1
292	LOTTIE ALDRICH	1	A	27	2
293	MRS. JOHN ZEIGLER	1	A	27	3
294	JOHN ZEIGLER	1	A	27	4
295	EMMETT N. BEAN	1	C	7	2
296	CORA E. BEAN	1	C	7	3
297	THOMAS FAHEY	1	C	12	1
298	"INFANT" REMINGTON	1	C	12	4
299	PHILIP BECK	1	C	17	1
300	JENNIE BECK	1	C	17	2
301	BYRON G. ASHDOWN	1	C	17A	1
302	(NOT APPLICABLE)				
303	WILLARD J. BEAN	1	A	17	8
304	LITTLE EVA ALDRICH	1	A	27	7
305	A.P. HALLOCK	1	C	2	1
306	BYRON REMINGTON	1	C	12	6
307	JEROME BERT REMINGTON	1	C	12	7
308	JAMES L HARRINGTON	1	C	17	4
309	NELLIE PLUMMER	1	A	1	1
310	MILO PLUMMER	1	A	1	2
311	LOUISE LONCTEAUX	1	A	1	3
312	EARL LONCTEAUX	1	A	1	4
313	PHOEBE M. HART	1	A	6	7
314	MATHEW B. HART	1	A	6	8
315	(NOT APPLICABLE)				
316	(NOT APPLICABLE)				
317	ALBERT FRANCE	1	A	16	5
318	MARY FRANCE	1	A	16	6
319	DEVILLO FRANCE	1	A	16	7
320	IDA L. FRANCE	1	A	16	8
321	W. W. REMINGTON	1	A	21	5
322	EMMA REMINGTON	1	A	21	6
323	GEORGE B. REMINGTON	1	A	21	8
324	MINNIE FRINK	1	A	26	6
325	KATE BURNSIDE	1	C	1	1
326	PHOEBE COOPER	1	C	1	2
327	A. J. MILLER	1	C	11	1
328	VIOLA MILLER	1	C	11	3
329	ANDREW MILLER	1	C	11	4
330	HOWARD CONSTANTINE	1	C	16	2
331	HAROLD CONSTANTINE	1	C	16	2
332	ROLLO PLUMMER	1	A	1	5
333	VIGRO PLUMMER	1	A	1	6
334	SIMION LONCTEAUX	1	A	1	7
335	CHILA KIDDER	1	A	6	1
336	RICHARD HART	1	A	6	4
337	ERWIN J. WEAGRAFF	1	A	11	1
338	UNKNOWN	1	A	11	7
339	CHRISTOFER NITZ	1	A	11	8
340	(NOT APPLICABLE)				
341	PEARL J. LEWIS	1	A	16	2
342	CELIA HUGHES	1	A	16	3
343	ROBY STIMSON	1	A	16	4
344	DELBERT REMINGTON	1	A	21	1
345	(NOT APPLICABLE)				
346	PEARL REMINGTON	1	A	21	2
347	(NOT APPLICABLE)				
348	MRS. CHARLES BURNSIDE	1	C	1	4
349	CHARLES BURNSIDE	1	C	1	5
350	JAMES BURNSIDE	1	C	1	6
351	MELVINA BURNSIDE	1	C	1	7
352	JAMES COWAN	1	C	6	1
353	MARY VIOLA MILLER	1	C	11	5
354	MARTIN MILLER	1	C	11	6
355	EDWARD J. SEE	1	C	11	8
151a	JOHANNAH GREENBERG	2	D	1	3
153a	HULDA WALLQUIST	2	D	6	2
154a	(NOT APPLICABLE)				
178a	EDWARD BUSBEE MOULD	1	A	30	2
183a	CLARA OGDEN	1	C	20	2
184a	BYRON ALDRICH	1	C	20A	2
184b	CHRISTINA ALDRICH	1	C	20A	4
207a	EVA MARIE JOHNSON	1	C	15	6
210a	ERNEST W. WEDIN	1	C	25	4
219a	"INFANT" GOODRICH	1	A	19	8
236a	LEROY BOUTELL	1	C	19	3
238a	CLYDE RYDER	1	C	24	1
238b	EZRA WRIGHT	1	C	24	5
238c	HARRIET L. WRIGHT	1	C	24	6
247a	ROBERT L. EATON	1	A	3	5
249a	CLARENCE H. BOVA	1	A	8	5
253a	VERN MARSH	1	A	18	4
255a	MARY RHODES	1	A	23A	2

(Graves 330 and 331: DOUBLE INTERMENT)

EXISTING CEMETERY (GREENWOOD)		REINTERMENT CEMETERY (STEAMBURG)			
GRAVE NO.	NAME OF INTERRED	SECTION	BLOCK	LOT	SPACE
268a	MARIAN HALLOCK	1	C	3	5
271a	ISAAC CORNELIUS	1	C	8	3
272a	PORTER CAMP	1	C	8A	2
272b	ELLEN CAMP	1	C	8A	1
273a	WILLIAM KNOWN	1	C	13	5
275a	MYRTLE MAE SEEKER	1	C	18	7
275b	"INFANT" HARRINGTON	1	C	18	8
278a	MRS. CHARLES YEAGER	1	A	2	5
278b	CHARLES YEAGER	1	A	2	6
290a	UNKNOWN	1	A	22	5
290b	"	1	A	22	6
290c	UNKNOWN	1	A	22	7
296a	LENA BEAN BROWN	1	C	7	4
297a	WILLIAM FAHEY	1	C	12	2
297b	JACK FAHEY	1	C	12	5
304a	"INFANT" ORVILLE ALDRICH	1	A	27	8
307a	SELECTA REMINGTON	1	C	12	8
308a	"INFANT" HARRINGTON	1	C	17	3
326a	HENRY COOPER	1	C	1	3
351a	JAMES BURNSIDE	1	C	1	8
352a	ELIZABETH H. COWAN	1	C	6	2
352b	JAMES COWAN JR.	1	C	6	3
352c	WILLIAM COWAN	1	C	6	4
352d	MRS. WILLIAM CLARK	1	C	6	6
352e	WILLIAM CLARK	1	C	6	7
352f	MABEL COWAN	1	C	6	8
250a	JOSEPH BOVA	1	A	8	4
254a	MRS. BURT ABBEY	1	A	23	2
305a	MRS. A.P. HALLOCK	1	C	2	2
339a	"INFANT" WEAGRAFF	1	A	11	5
339b	"INFANT" WEAGRAFF	1	A	11	6
339c	FRANCES WEAGRAFF	1	A	11	3
196a	"INFANT" FRINK	1	A	25	1
265a	ANSON D. BOVA	1	A	8	8
257a	WALTER H. HEIDELL	1	A	28	4
331a	UNKNOWN	3	F	17	1
238d	JUNIE C. RYDER	1	C	24	7
339d	JOHN C. WEAGRAFF	1	A	11	4
357	MAUDE E. GOODRICH	2	B	2	5
358	UNKNOWN	1	C	16	1
359	"	1	C	16	5
360	"	1	C	16	6
361	(NOT APPLICABLE)				
362	UNKNOWN	1	C	16	8
363	"	1	C	16	7
364	"	1	C	21	1
365	"	1	C	21	2
366	"	1	C	21	3
367	"	1	C	21	4
368	"	1	C	21	5
369	"	1	C	21	6
370	"	1	C	21	7
371	"	1	C	21	8
372	"	1	C	22	1
373	"	1	C	23	1
374	"	1	C	23	2
382	"	1	C	22	2

(Grave 357: INTERMENT BY PRIVATE FUNERAL ON 7/12/64.)

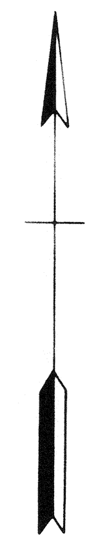

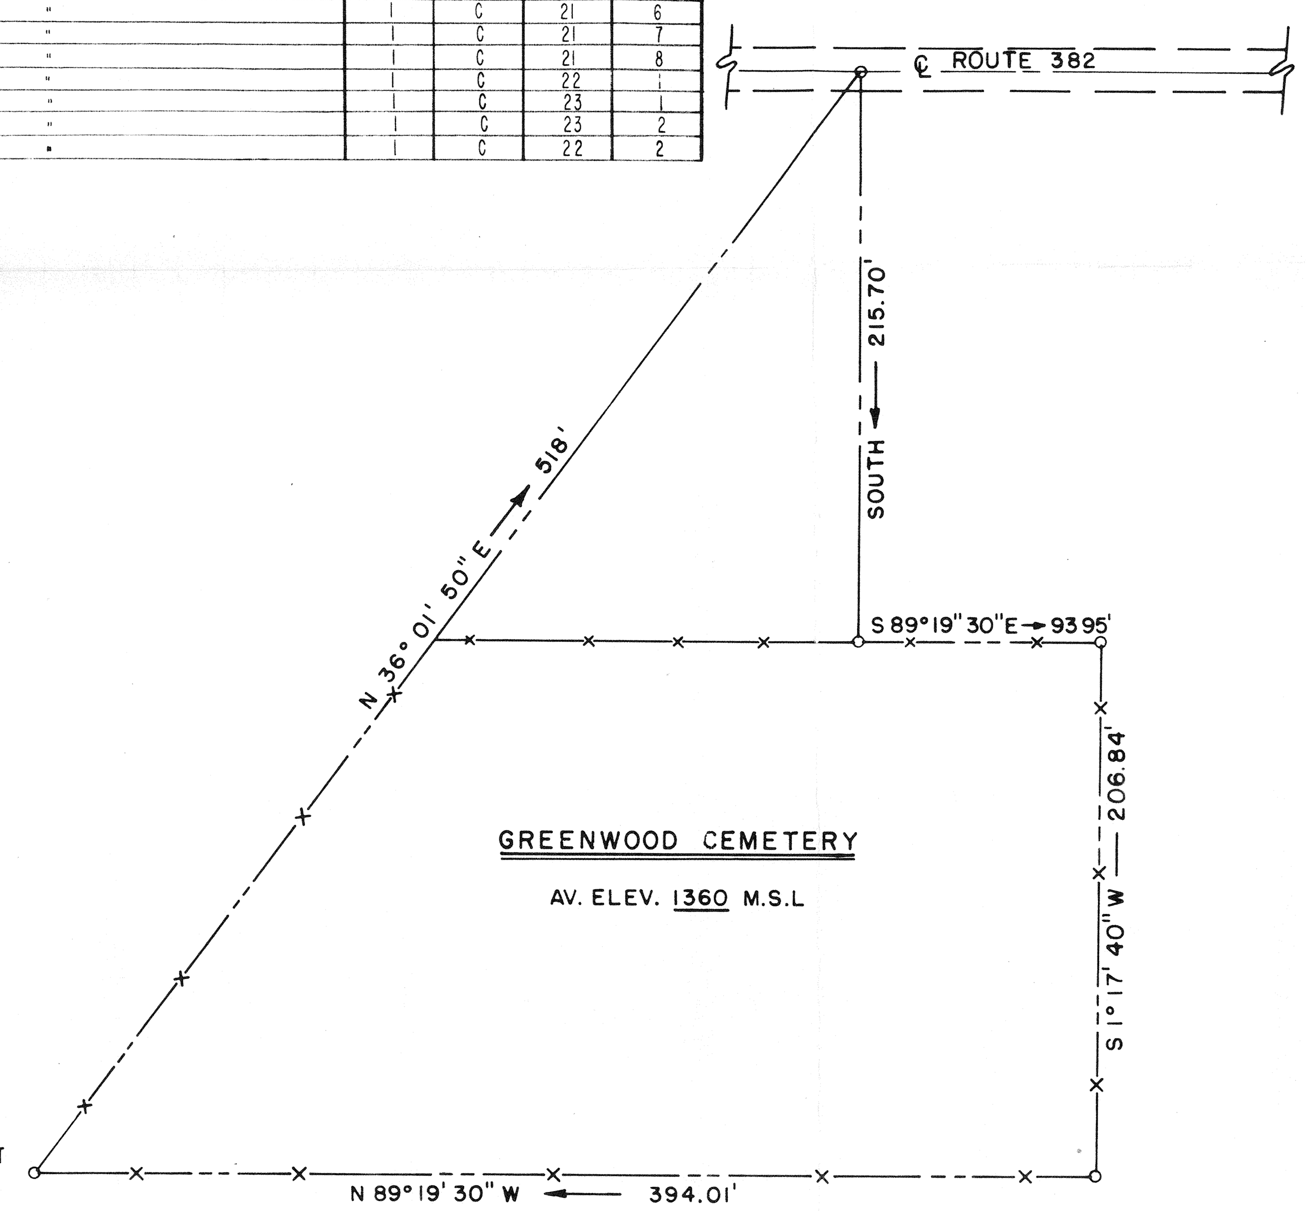

GREENWOOD CEMETERY

AV. ELEV. 1360 M.S.L

TRACT DESCRIPTION

SCALE: 1" = 50'

LEGEND

- Cemetery Boundary Mark
- Lot Corner Mark
- Family Monument
- Headstone
- Footstone
- Veterans Marker
- Tree, Shrub, Bush, Plant
- Planter
- Fence & Property Line
- Fence
- Fieldstone

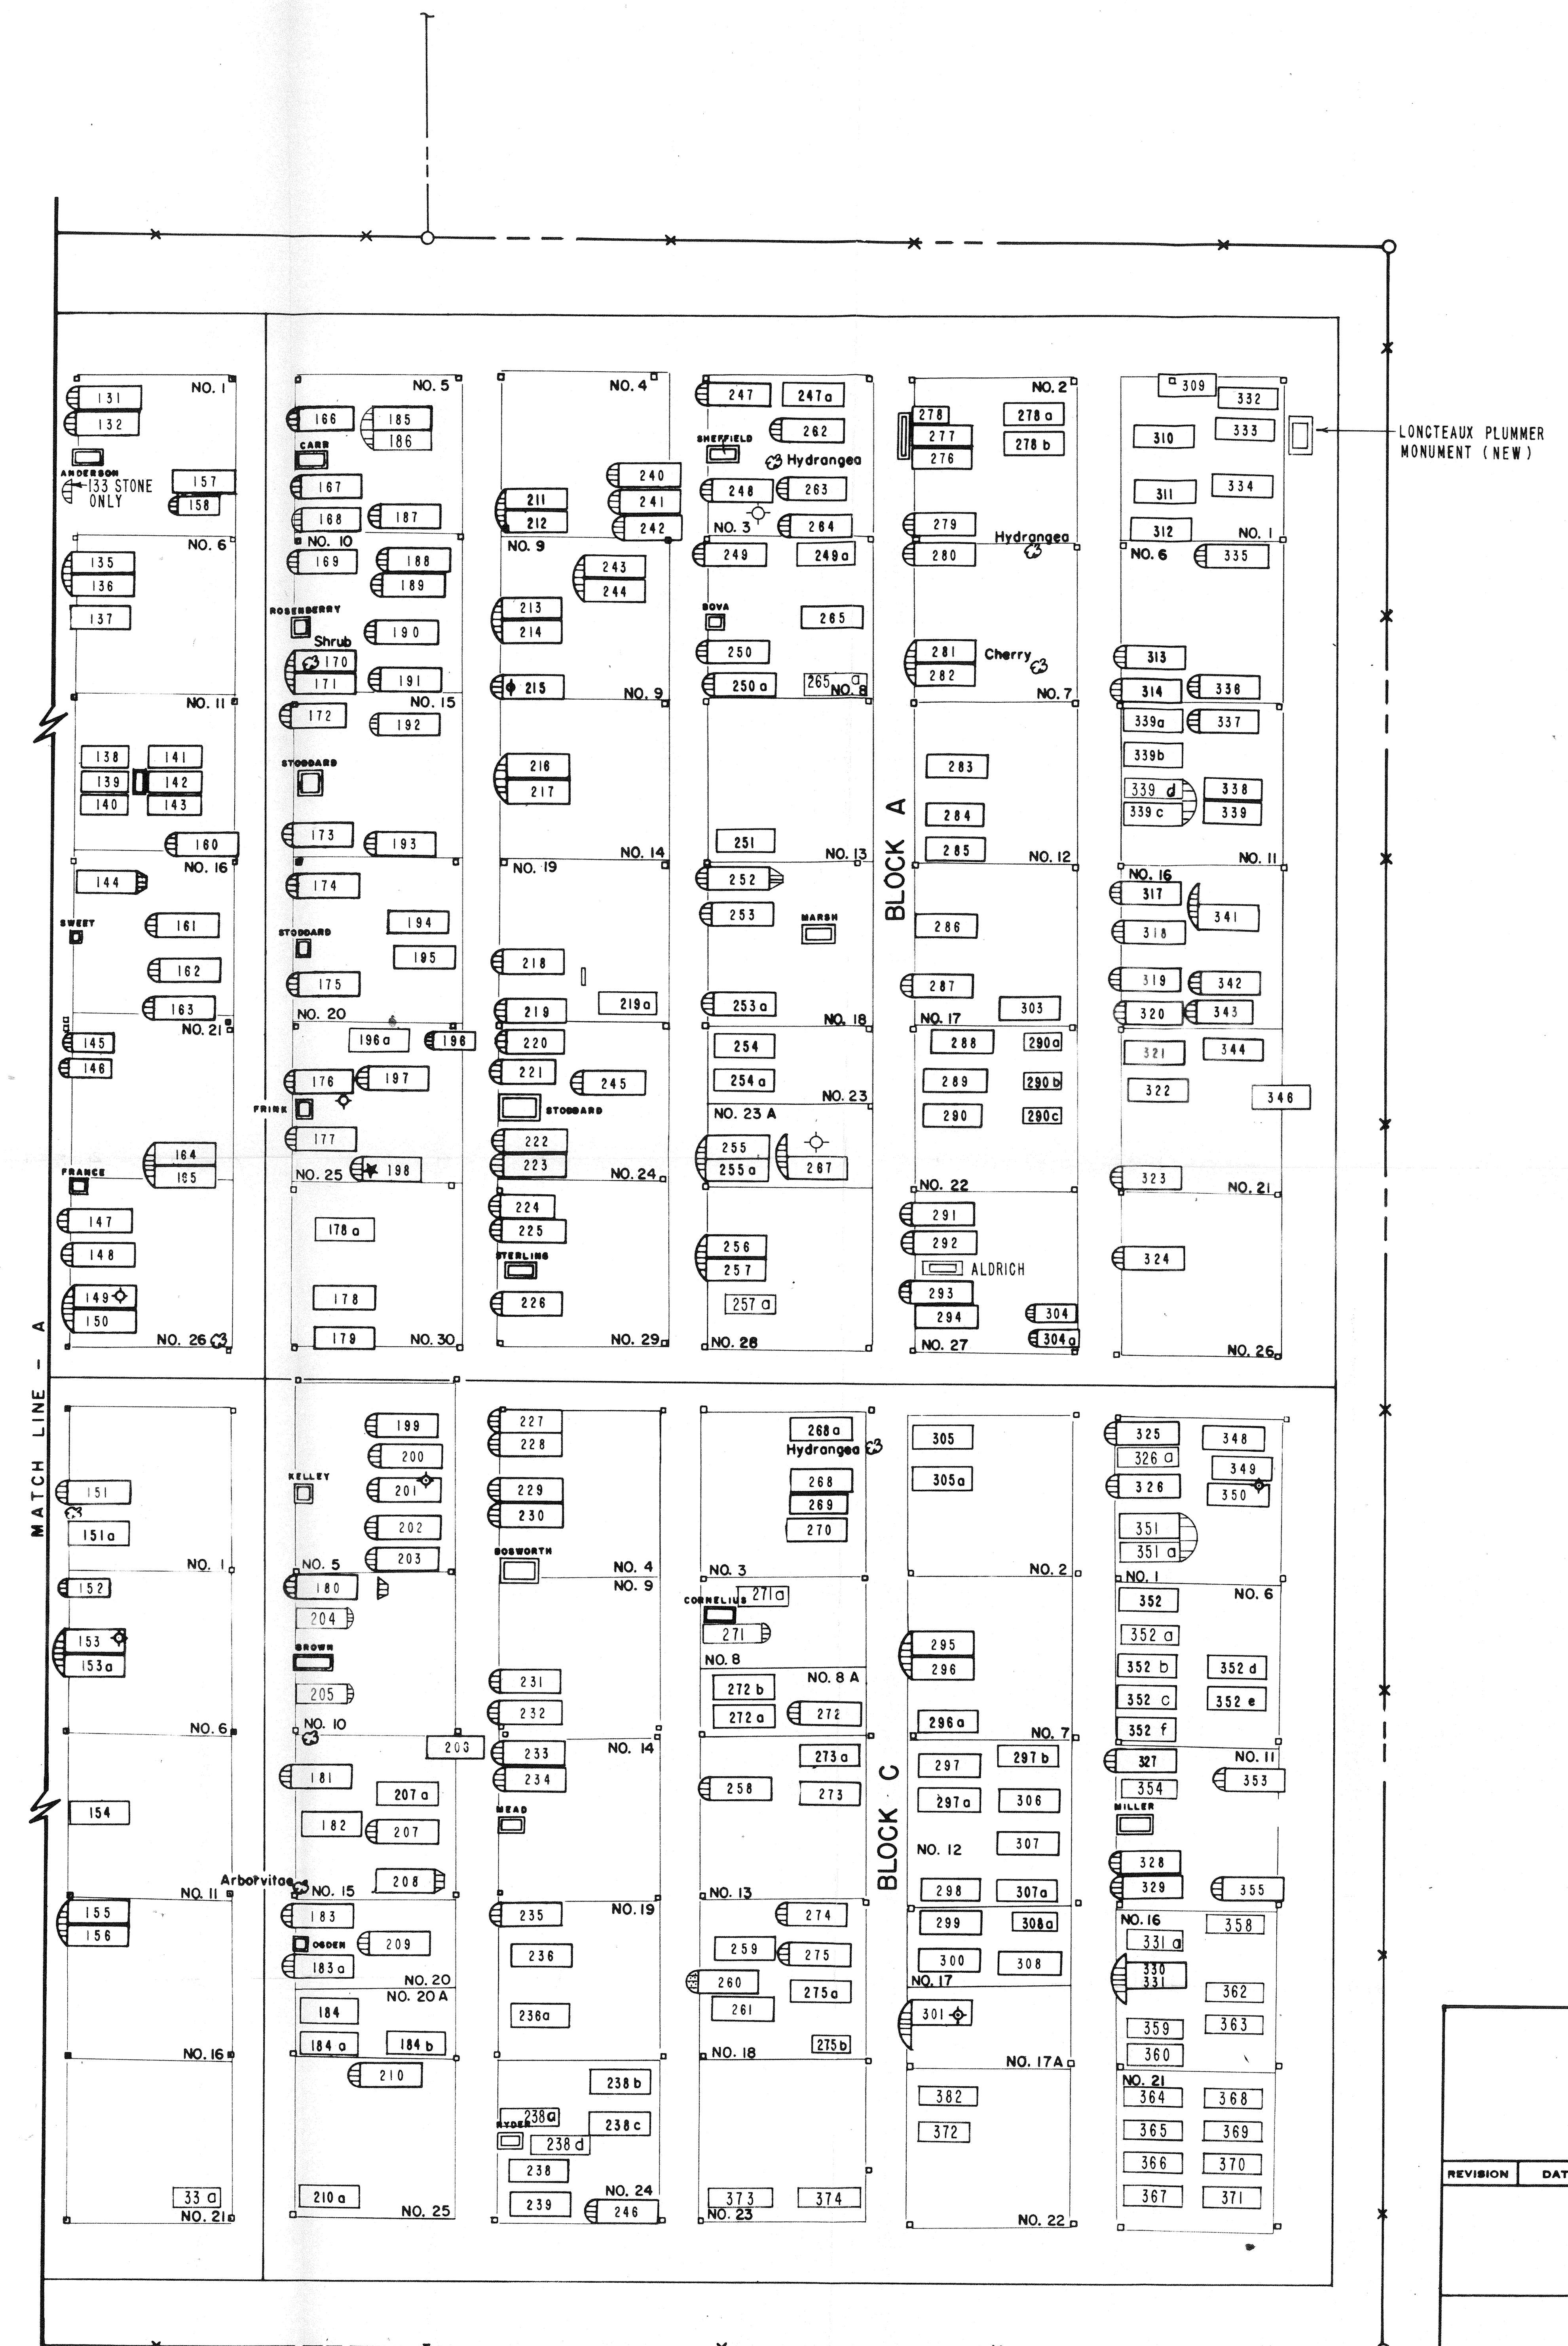

EXISTING CEMETERY (GREENWOOD)		REINTERMENT CEMETERY (STEAMBURG)			
GRAVE NO.	NAME OF INTERRED	SECTION	BLOCK	LOT	SPACE
131	PERRY ANDERSON	2	B	1	1
132	HARRIET ANDERSON	2	B	1	2
133	(NOT APPLICABLE)	2	B	1	3
134	(NOT APPLICABLE)	2	B	1	4
135	DAVID CARGILL	2	B	6	2
136	BETSY CARGILL	2	B	6	1
137	JOHNNY R. GODFREY	2	B	6	3
138	BLANCHE E. STANTON	2	B	11	1
139	GEORGE T. STANTON	2	B	11	2
140	JOSEPHINE STANTON	2	B	11	3
141	SNELL BUSHNELL	2	B	11	5
142	LEROY BUSHNELL	2	B	11	6
143	ELIZA BUSHNELL	2	B	11	7
144	WILLIS SWEET	2	B	16	1
145	MAY FRANCE	2	B	21	1
146	CECIL FRANCE	2	B	21	2
147	ALONZO FRANCE	2	B	26	1
148	SERENA FRANCE	2	B	26	2
149	FANNIE F. CROYLE	2	B	26	3
150	JOHN N. CROYLE	2	B	26	4
151	MABEL ELEANOR GREENBERG	2	D	1	2
152	HARRY R. WALLQUIST	2	D	6	1
153	CARL A. WALLQUIST	2	D	6	3
154	LULO BUSHNELL	2	D	11	3
155	SARAH J. MEDLEY	2	D	16	2
156	JOHN MEDLEY	2	D	16	1
157	LAWRENCE ANDERSON	2	B	1	7
158	ROLAND ANDERSON	2	B	1	8
159	(NOT APPLICABLE)				
160	EVERAL STANTON	2	B	11	8
161	RUSSEL L. SWEET	2	B	16	6
162	SARAH J. SWEET	2	B	16	7
163	THEOPHILIS SWEET	2	B	16	8
164	NELLIE FRANCE	2	B	21	8
165	ERNEST FRANCE	2	B	21	7
166	HOWARD CARR	1	A	5	2
167	OLINDA CARR	1	A	5	3
168	EMMA M. CONRAD	1	A	5	4
169	HAZEL ROSENBERRY	1	A	10	1
170	JAMES F. ROSENBERRY	1	A	10	3
171	ALICE M. ROSENBERRY	1	A	10	4
172	ROBERT STODDARD	1	A	15	1
173	MARY ANN STODDARD	1	A	15	4
174	MARY L. STODDARD	1	A	20	1
175	MARSHALL STODDARD	1	A	20	4
176	JAMES D. FRINK	1	A	25	2
177	JANE FRINK	1	A	25	3
178	ELLA ESTELLE MOULD	1	A	30	3
179	EMMA L. MOULD	1	A	30	4
180	KATE H. BROWN	1	C	10	1
181	LOUIS N. REMINGTON	1	C	15	2
182	ALICE REMINGTON	1	C	15	3
183	HELON OGDEN	1	C	20	1
184	JAMES M. ALDRICH	1	C	20A	1
185	J HOMER CARR	1	A	5	6
186	LILLIAN IRENE CARR	1	A	5	7
187	ELIZABETH O. CARR	1	A	5	8
188	JAMES ROSENBERRY	1	A	10	5
189	THOMAS ROSENBERRY	1	A	10	6
190	CHARLOTTE L. ROSENBERRY	1	A	10	7
191	SARAH ROSENBERRY	1	A	10	8
192	ELLA ALDRICH	1	A	15	5
193	MYRTLE B. JOHNSON	1	A	15	8
194	JASON BENNETT	1	A	20	6
195	HETTIE BENNETT	1	A	20	7
196	"INFANT" FRINK	1	A	25	5
197	HARRY W. HALE	1	A	25	6
198	WILLIAM A. FRINK	1	A	25	8
199	DAVID W KELLEY	1	C	5	2
200	SARAH J. KELLEY	1	C	5	3
201	WILLIAM D. KELLEY	1	C	5	4
202	ALICE E. KELLEY	1	C	5	8
203	PATTY KELLEY	1	C	5	7
204	GEORGE W. BROWN	1	C	10	6
205	ROSENA BROWN	1	C	10	8
206	UNKNOWN	1	C	15	5
207	ROLAND REMINGTON	1	C	15	7
208	FRANK REMINGTON	1	C	15	8
209	CHARLEY H. OGDEN	1	C	20	3
210	B.L. JOHNSON	1	C	25	1
211	ALMIRA CARR	1	A	4	3
212	STEPHEN CARR	1	A	4	4
213	CAROLINE HERTEL	1	A	9	2
214	HENRY HERTEL	1	A	9	3
215	RAYMOND R. DURPHY	1	A	9	4
216	SARAH DUNBAR	1	A	14	2
217	SYLVESTER V. DUNBAR	1	A	14	3
218	AMELIZA BROWN	1	A	19	3
219	THOMAS BROWN	1	A	19	4
220	CALVIN STODDARD	1	A	24	1
221	GILES STODDARD	1	A	24	2
222	SARAH M. STODDARD	1	A	24	3
223	MARY ANN STODDARD	1	A	24	4
224	CLARA A. STERLING	1	A	29	1
225	CHARLES A. STERLING	1	A	29	2
226	BERTHA MESSINGHAM STERLING	1	A	29	4
227	FRANK H. BOSWORTH	1	C	4	1
228	MARY BOSWORTH	1	C	4	2
229	CLARK W. BOSWORTH	1	C	4	3
230	SUSAN S. BOSWORTH	1	C	4	4

REVISION	DATE	DESCRIPTION	BY

GRAPHIC SCALE 10' 5' 0 10' 20'

U. S. ARMY ENGINEER DISTRICT, PITTSBURGH
CORPS OF ENGINEERS
OFFICE OF THE DISTRICT ENGINEER
PITTSBURGH, PENNSYLVANIA

OCT 15 1965

ALLEGHENY RESERVOIR
ALLEGHENY RIVER
CEMETERY RELOCATIONS
GREENWOOD CEMETERY
LAYOUT PLAN - SHEET 2

PREPARED BY: F. D.
DRAWN BY: R. W. - P. D.
CHECKED BY: FD
SUBMITTED BY: [signature] CHIEF, RELOCATIONS BRANCH
APPROVAL RECOMMENDED: [signature] CHIEF, ENGINEERING DIVISION
APPROVED: [signature] COLONEL, CORPS OF ENGINEERS, DISTRICT ENGINEER
DATE: 9 OCTOBER 1963
APPROVED FOR:
DATE:
SCALE: AS SHOWN SPEC. NO.:
DRAWING NUMBER 038-U1-69/87A
SHEET 7 OF 9

"AS BUILT" 16 OCTOBER 1964 THIS DRAWING SUPERSEDES DRAWING 69/87